



SECOND FLOOR PLAN

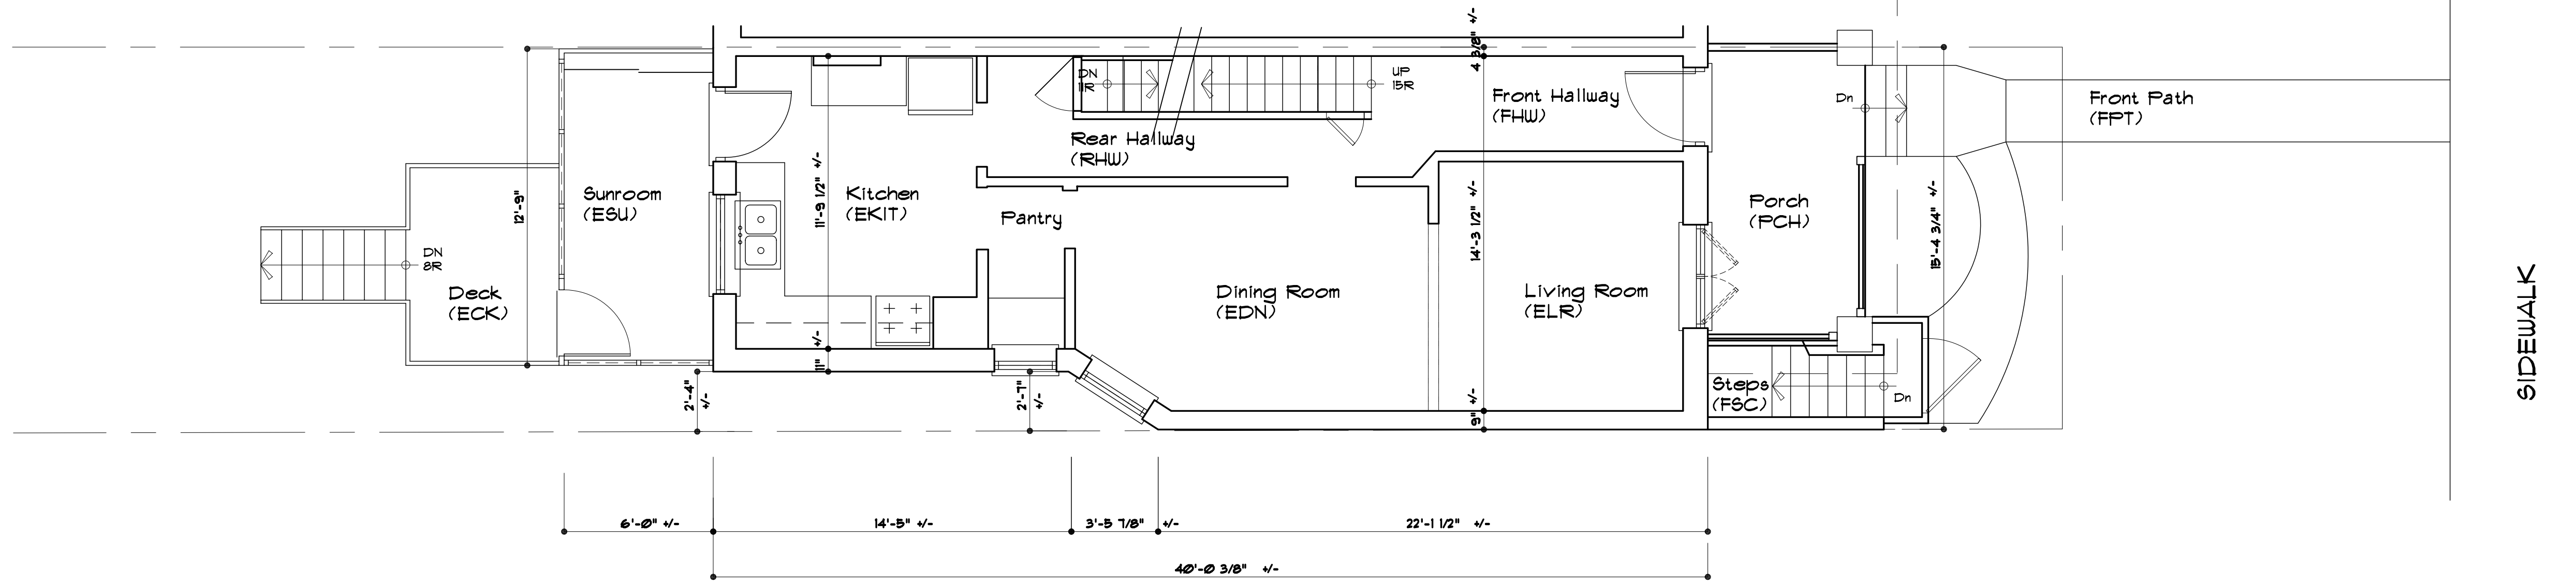

GROUND FLOOR PLAN

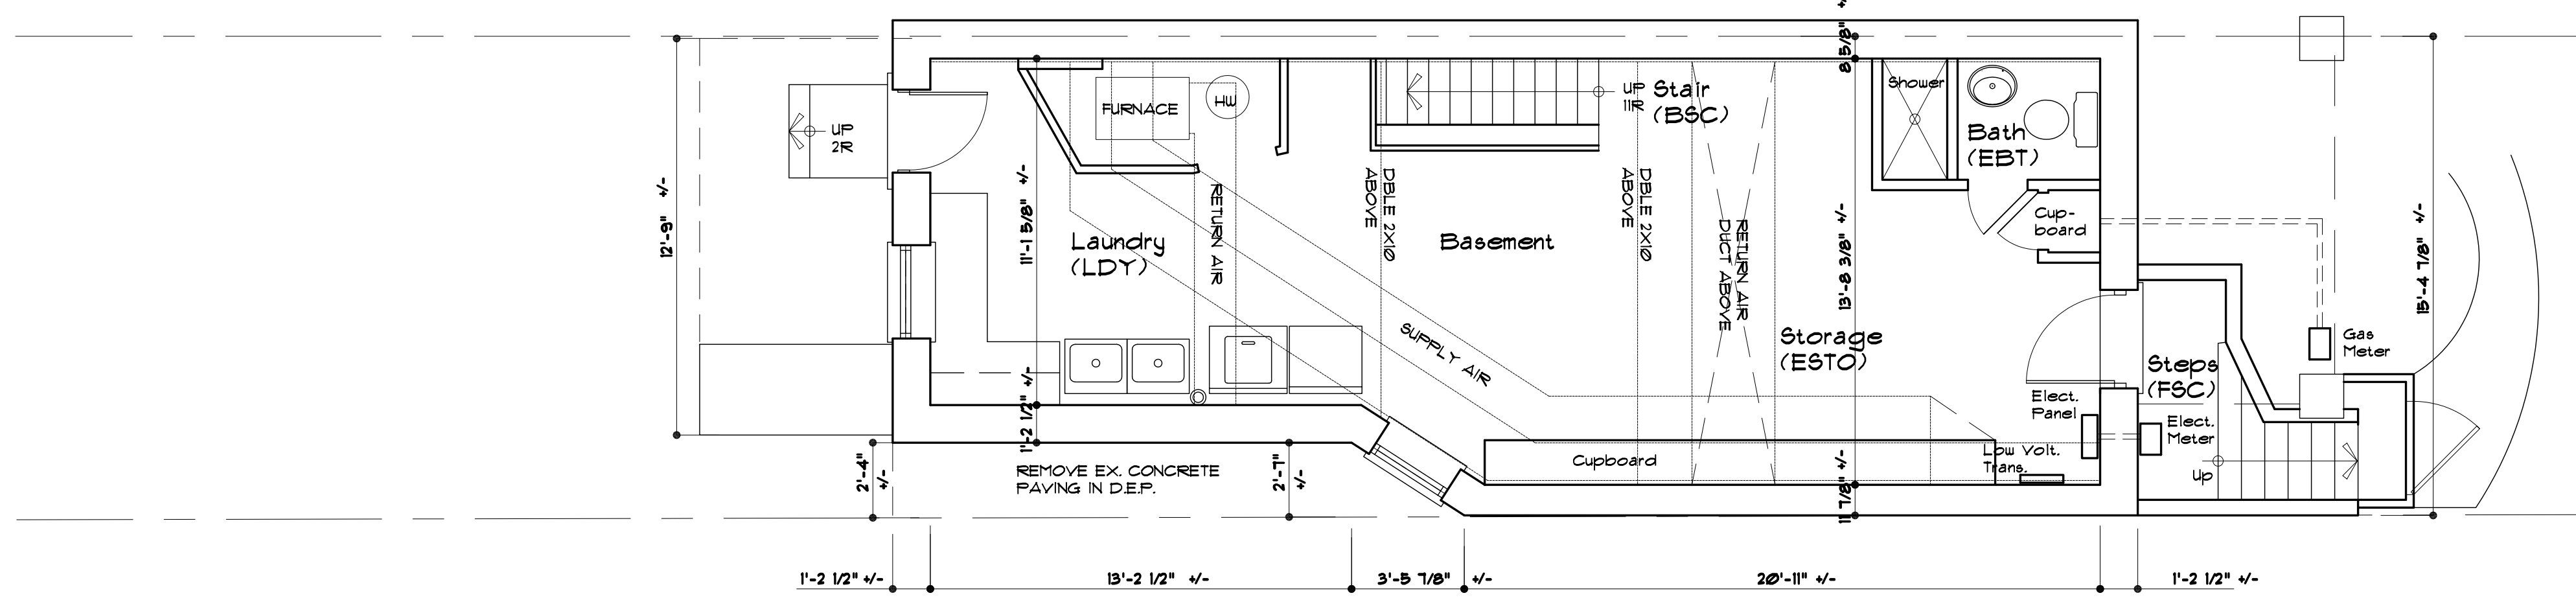

BASEMENT PLAN

- NOTES
1. VERIFY ALL DIMENSIONS PRIOR TO CONSTRUCTION.
 2. DO NOT SCALE DRAWINGS.
 3. REPORT ALL DISCOVERIES OF ERRORS, OMISSIONS OR DISCREPANCIES TO THE ARCHITECT OR DESIGN ENGINEER AS APPLICABLE.
 4. USE ONLY LATEST REVISED DRAWINGS OR THOSE THAT ARE MARKED "ISSUED FOR CONSTRUCTION."
 5. THE DRAWINGS ARE THE PROPERTY OF THE ARCHITECT AND/OR ENGINEER AND MUST BE RETURNED ON COMPLETION OF THE PROJECT. ANY UNAUTHORIZED USE IS PROHIBITED.
 6. ALL AREA CALCULATIONS ARE APPROXIMATE.

No.	DATE	MADE	ISSUED FOR
1	02.10.31	RH	CLIENT REVIEW
2	02.11.22	RH	PRICING
3	03.01.21	RH	BUILDING PERMIT
4	03.04.01	RH	REISSUED FOR BLDG. PERMIT
5	03.05.02	RH	CLIENT PRICING
6	03.05.01	RH	CLIENT REVIEW
7	03.05.28	RH	ALTER PERMIT

No.	DATE	MADE	DESCRIPTION
2	03.05.02	RH	CLIENT COMMENTS
1	03.04.01	RH	CITY COMMENTS

REVISIONS

WILLIAM H.D. HURST
LICENCE
2418

WHA Architects Inc

1842 QUEEN STREET EAST, TORONTO, ONT., M4L 1H1
PH: (416) 693-9717 FAX: (416) 693-9732

Proposed
Addition / Renovation
for
24 Devon Road

Toronto Ontario

TITLE

As Built Floor Plans

SCALE	DATE	DRAWN	CHECKED
1/4"=1'-0"	02/10/31	rh	wh
PROJECT No.	02118	DRAWING No.	A-2ab

SIDEWALK